



**BAPS Swaminarayan Sanstha
Shri Swaminarayan Mandir**

5601 Pritchard Drive
North Little Rock, Arkansas 72117
t: (501) 945-3388 f: (501) 327-9388

www.baps.org | www.swaminarayan.org

BAPS Hindu Temple

5601 Pritchard Dr, North Little Rock, AR 72117

501-269-8999

501-329-7744

July 8th, 2026

Shawn Spencer
Planning Department
700 W 29th St.
NLR, AR 72114

RE: Site Plan Review
Lot 9A, 9B, 9R-2
Straw's Addition
Storage Units

Mr. Spencer,

Please accept this letter to serve as our application for the above referenced submittal. We wish to be placed at the August 10th Planning Commission meeting. We are requesting that the site plan be accepted for review.

The owner is requesting existing lots 9R-2 to be used as storage units.

The owner is requesting to renew the site plans.

Enclosed please find a check for the review fee in the amount of \$170.00

If you have any questions, please give me a call.

Sincerely,
Raj Vyas
501-269-8999
Raju.Vyas@hilton.com


EXHIBIT A

LEGAL DESCRIPTION

LOT 9A, LOT 9B AND LOT 9R-2

STRAWN'S ADDITION

**NW ¼ AND THE NE ¼ SECTION 29 TOWNSHIP 2 NORTH, RANGE 11 WEST PULASKI
COUNTY, ARKANSAS: LOT 9A, LOT 9B AND LOT 9R-2 STRAWN'S ADDITION TO THE
CITY OF NORTH LITTLE ROCK, PUALSKI COUNTY ARKANSAS**

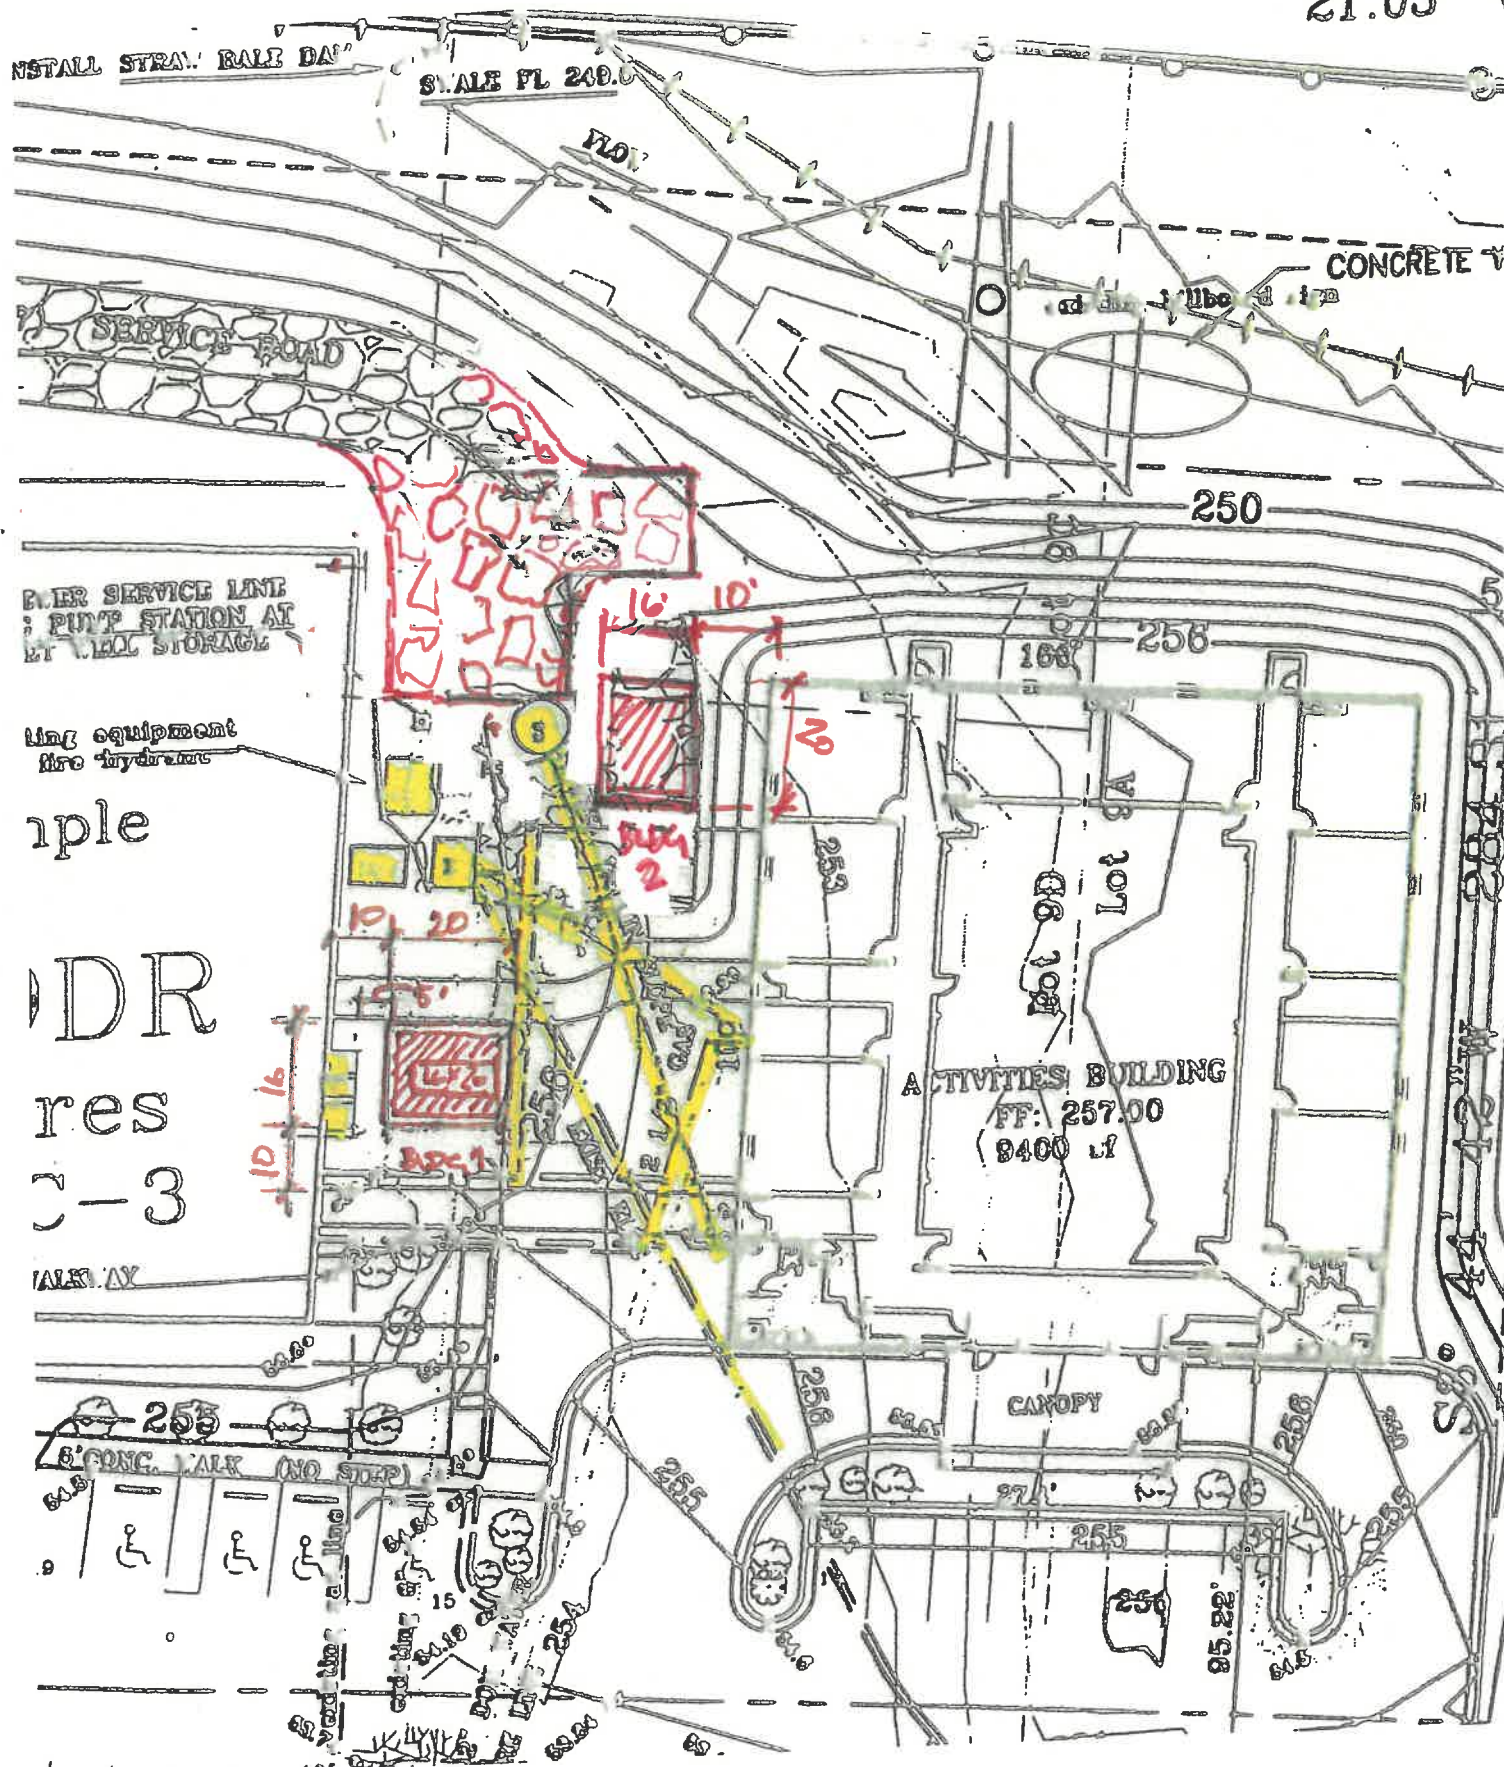

OPTION 2 - NO VARIANCE REQUIRED (BOTH BUILDINGS MEET ZONING CODE REQUIRED)

LOOK SCALE: 1" = 30'-0"